


Asia

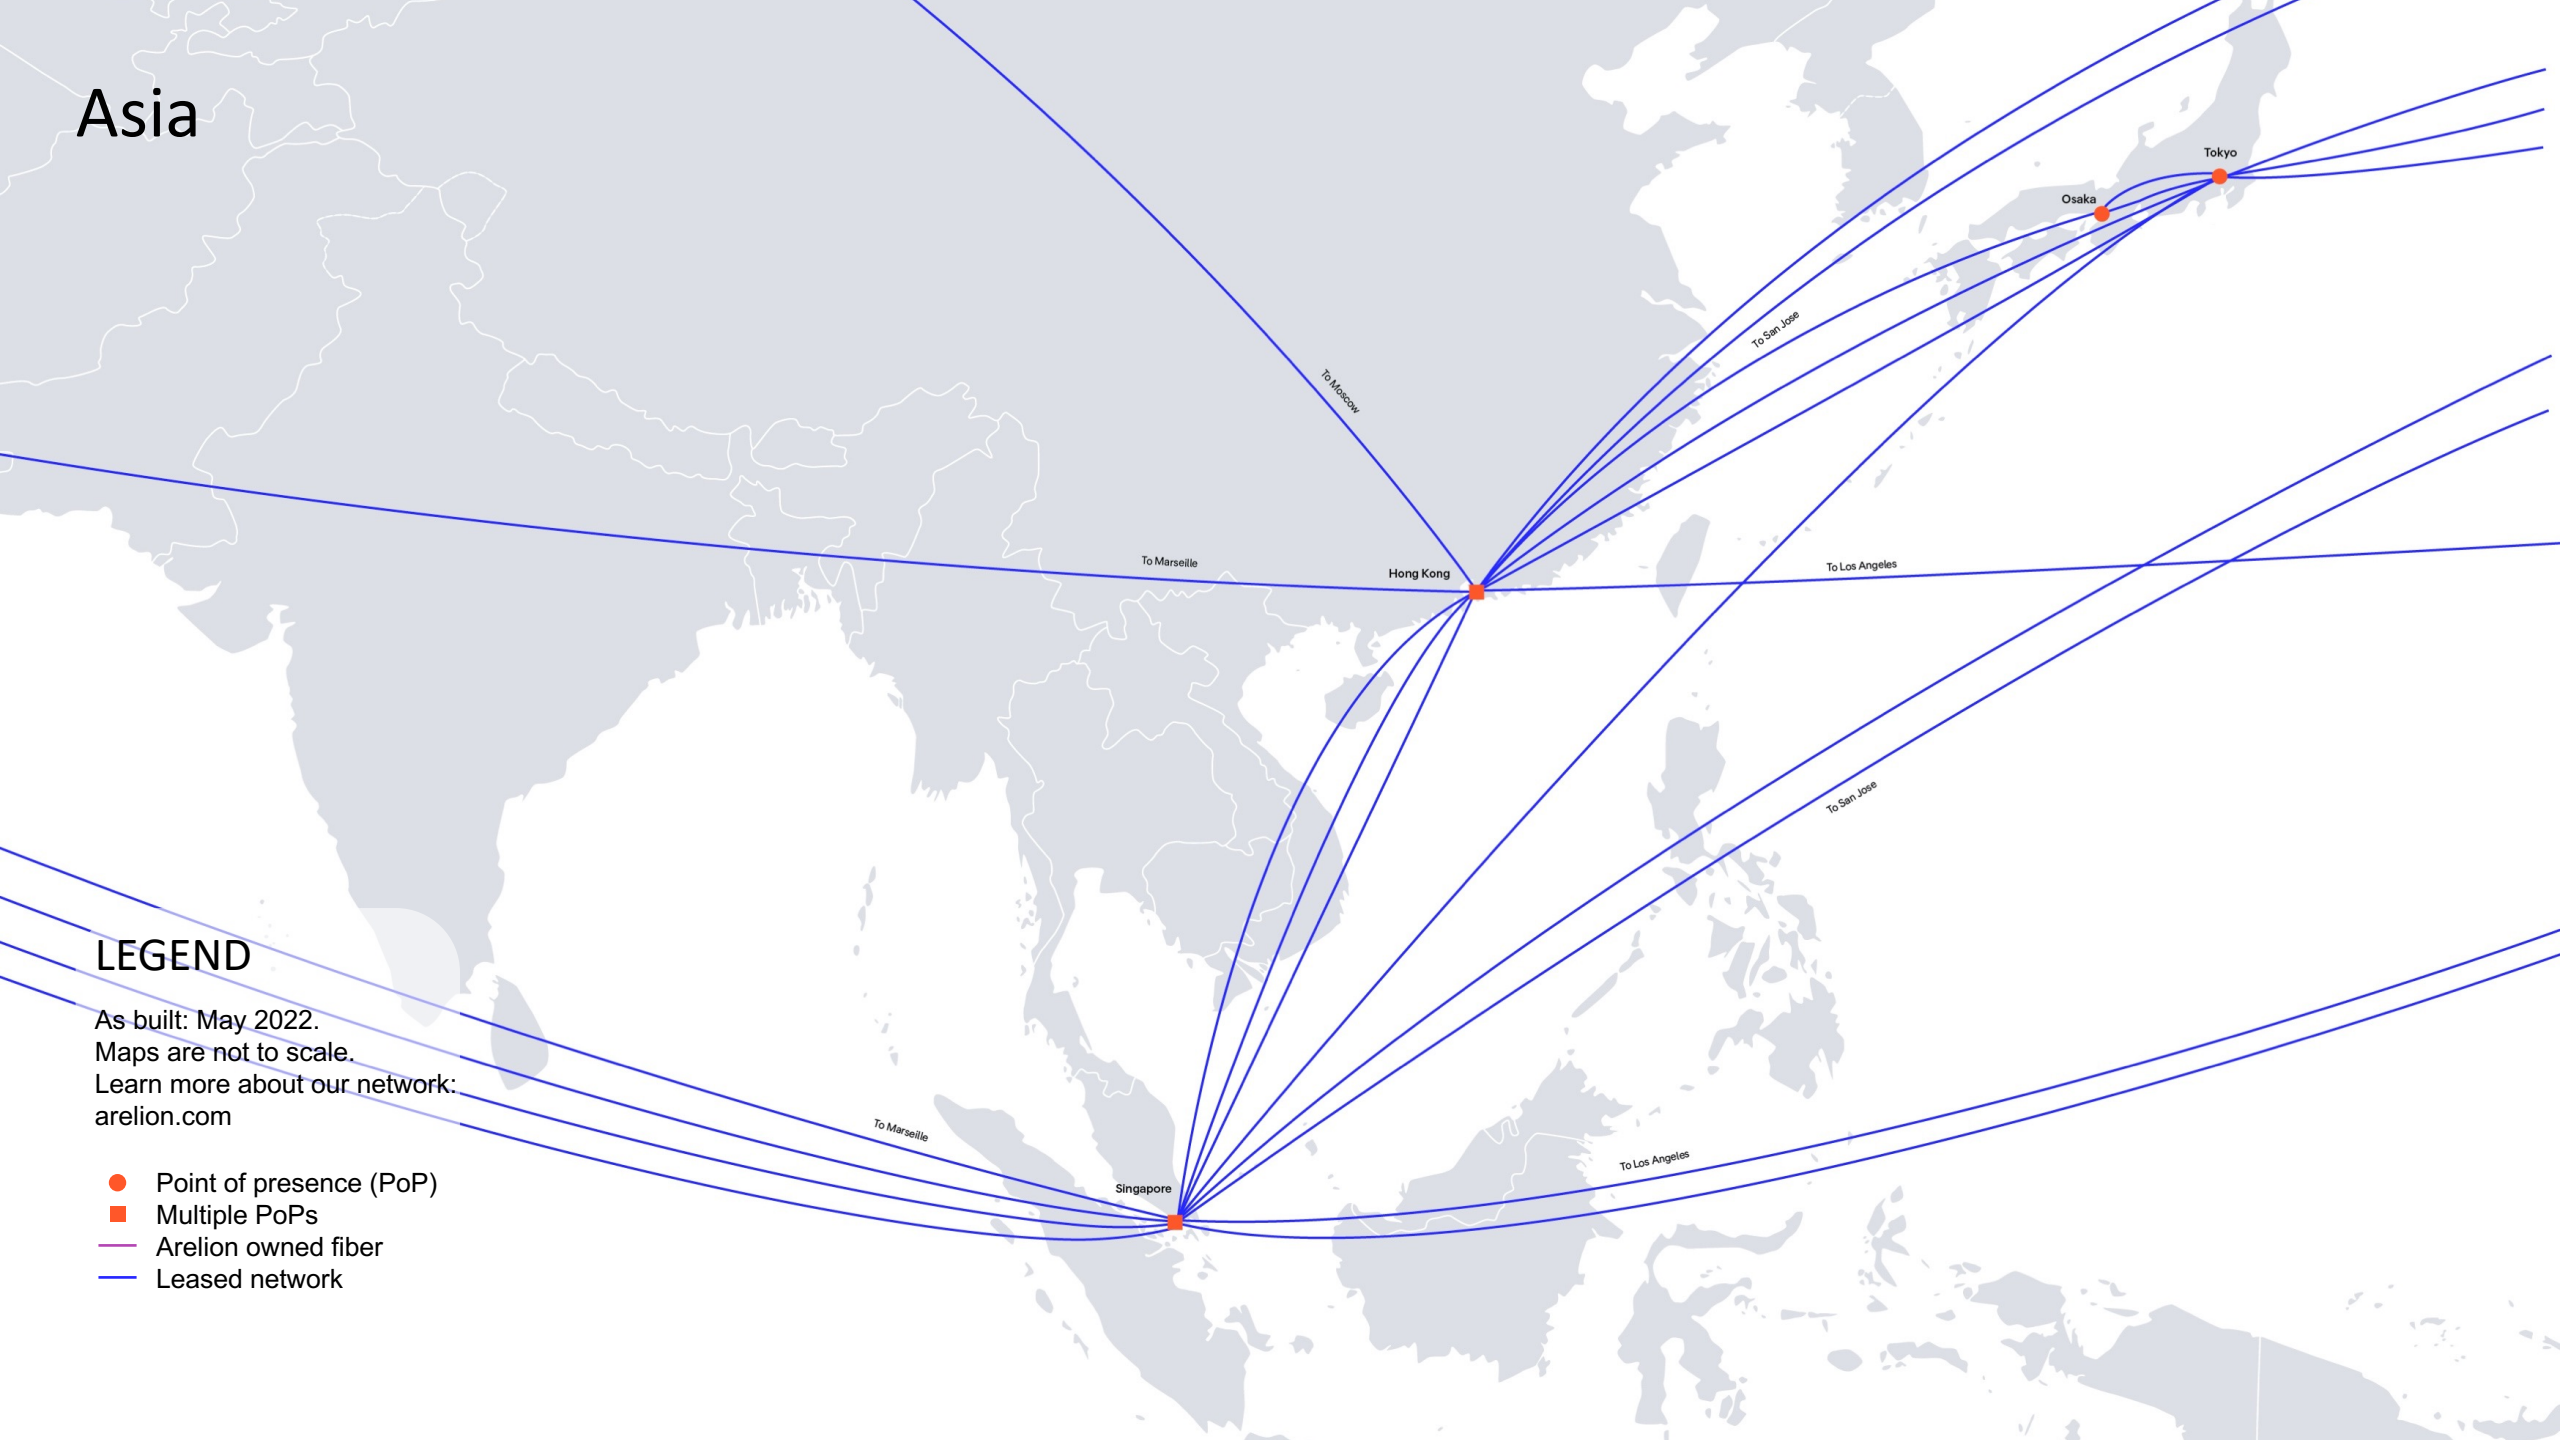

LEGEND

As built: May 2022.
Maps are not to scale.
Learn more about our network:
arelion.com

- Point of presence (PoP)
- Multiple PoPs
- Arelion owned fiber
- Leased network

Our PoPs in Asia

Hong Kong

399 Chai Wan Rd, MEGA-i Advantage
168 Yeung Uk Rd, Equinix

Osaka

1-26-1 Shinmachi Nishi-ku, Equinix OS1

Singapore

Block 20, Ayer Rajah Crescent, Equinix
Tai Seng Ave 2, Global Switch

Tokyo

Higashishinagawa 3-8-21, Equinix TY2

